

Redline Version of  
 Drawings: Not for  
 Publication

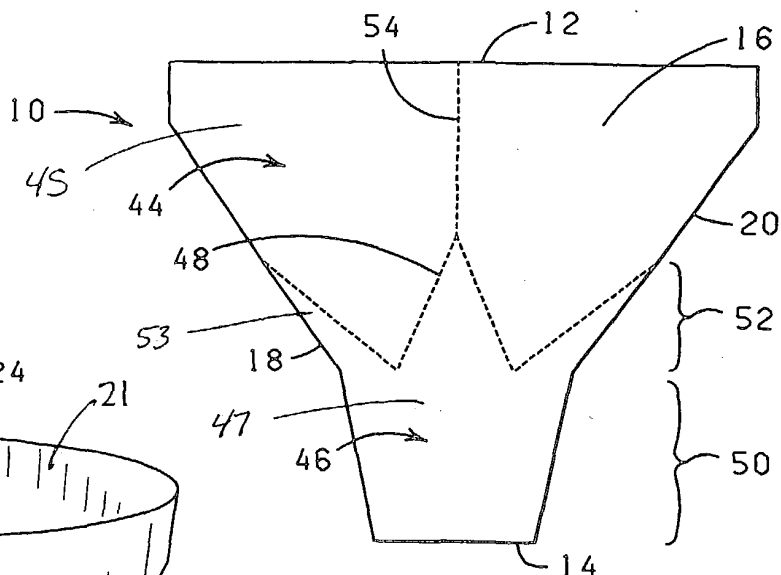


FIG. 1

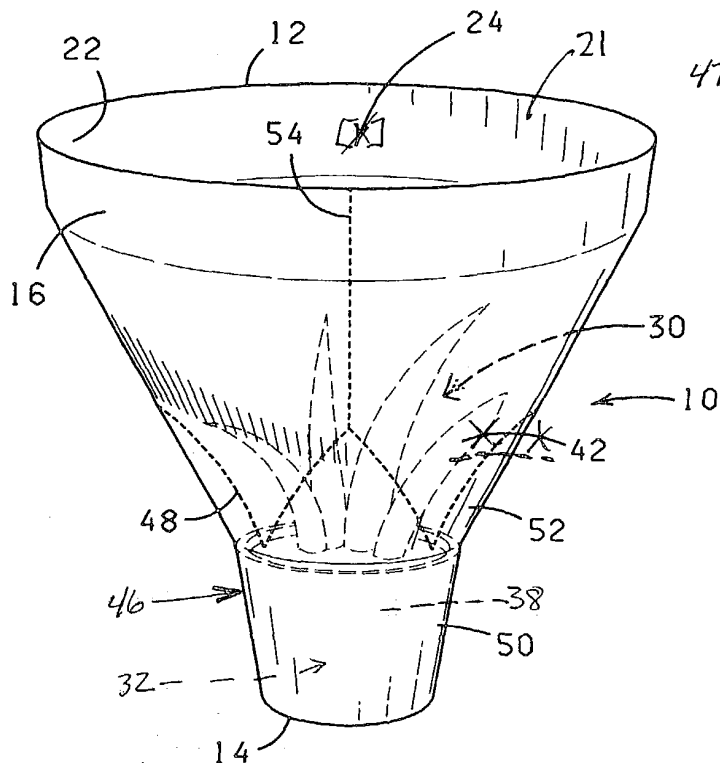


FIG. 2

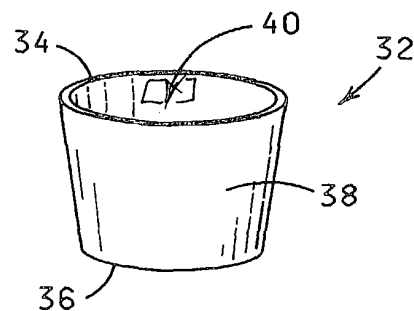


FIG. 3

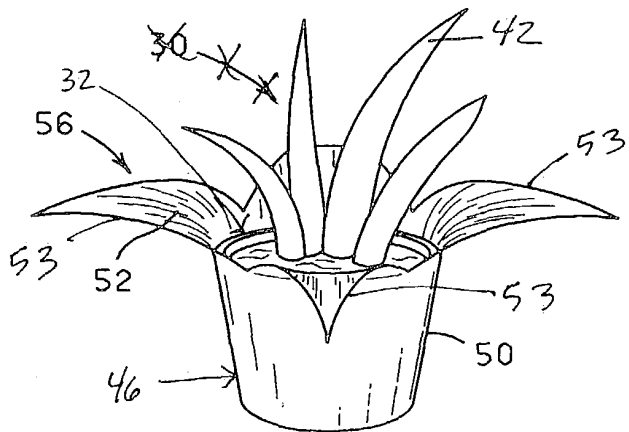


FIG. 4

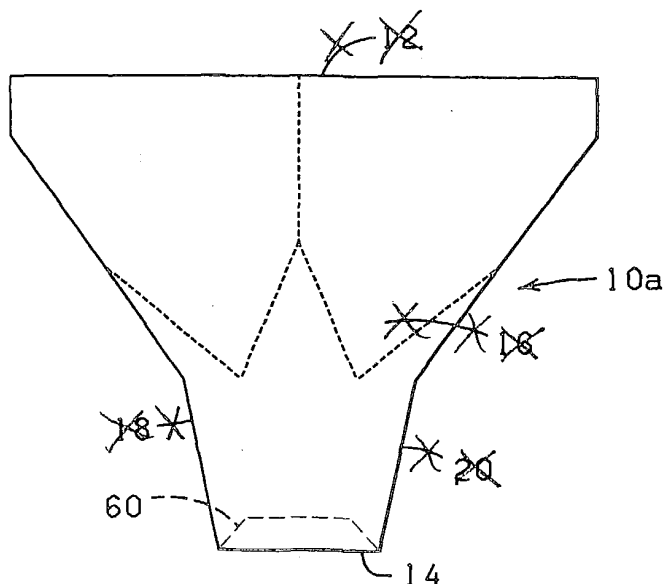
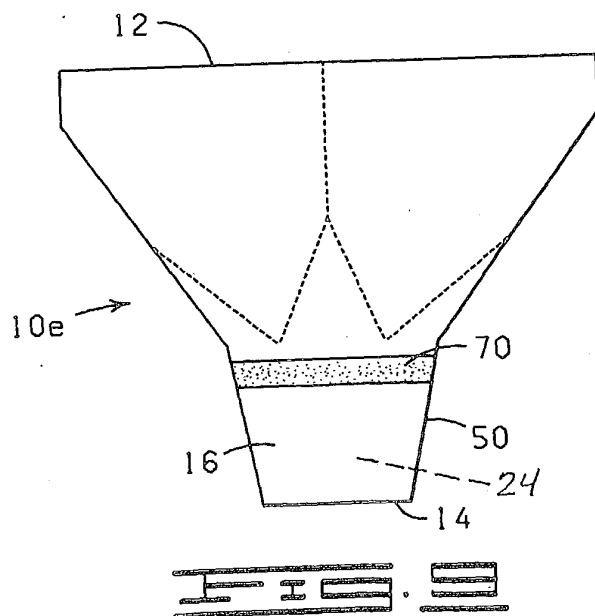
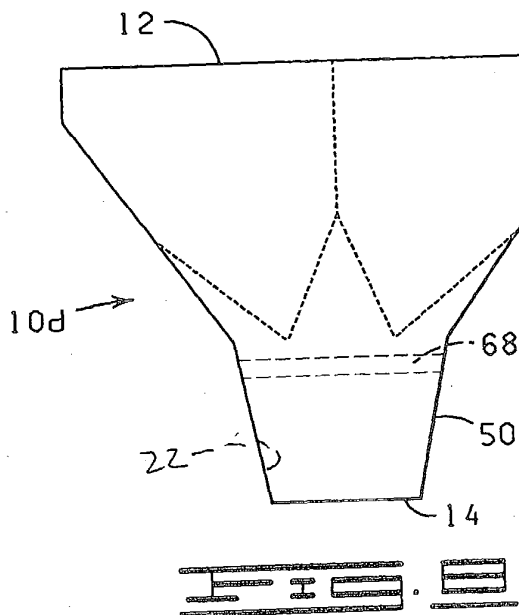
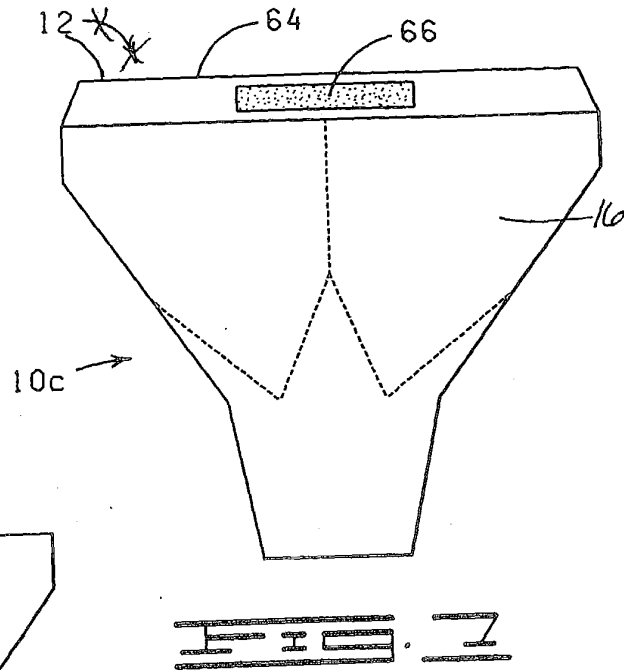
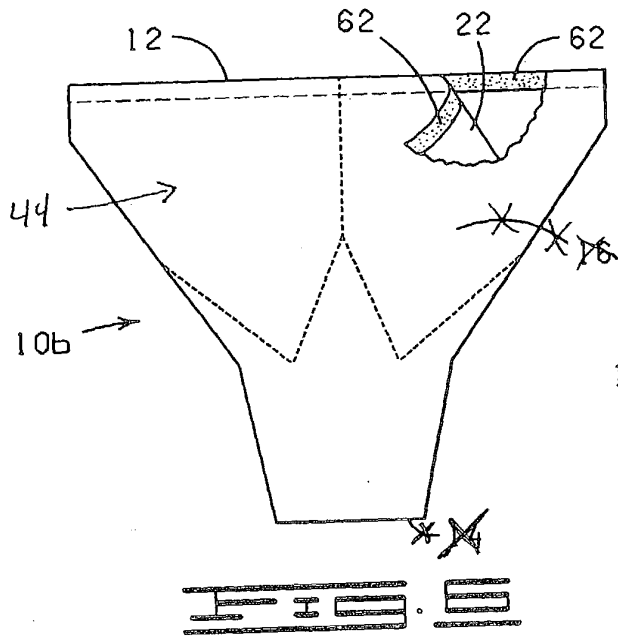


FIG. 5



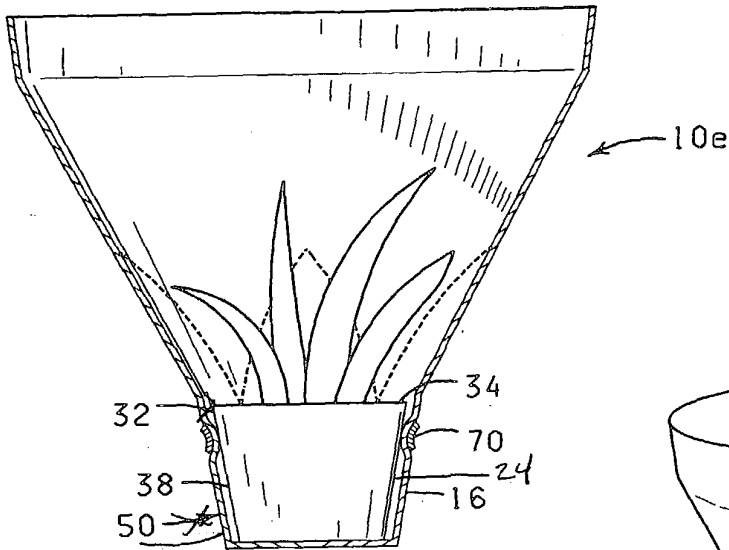


FIG. 10

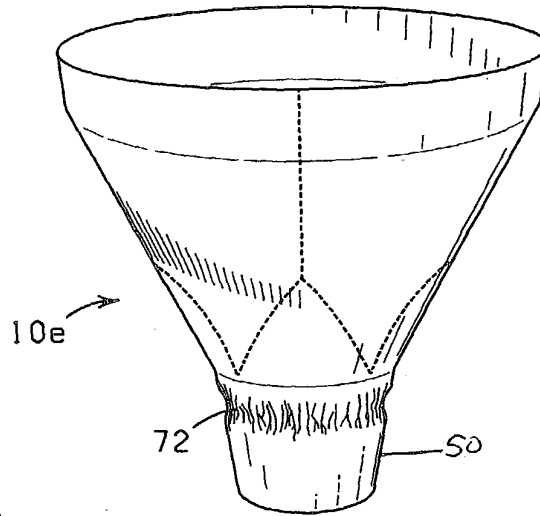


FIG. 11

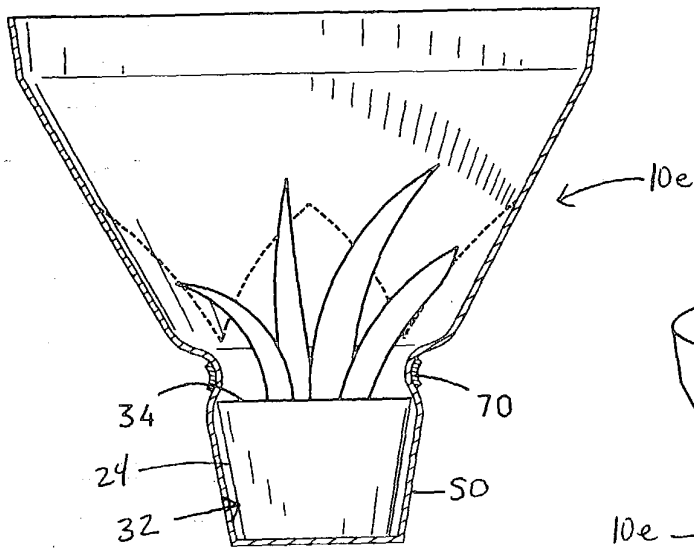


FIG. 12

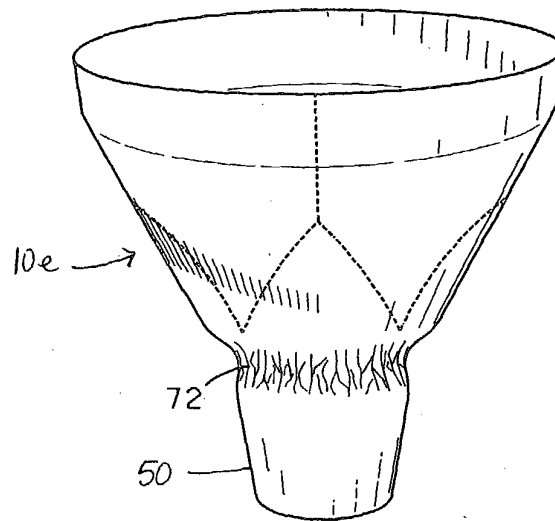
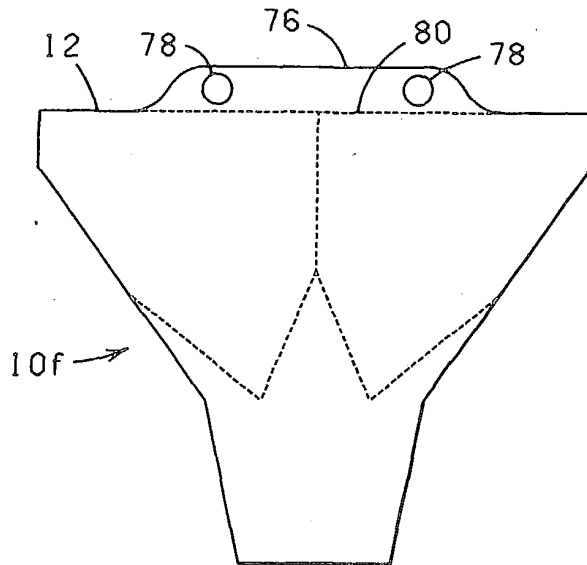
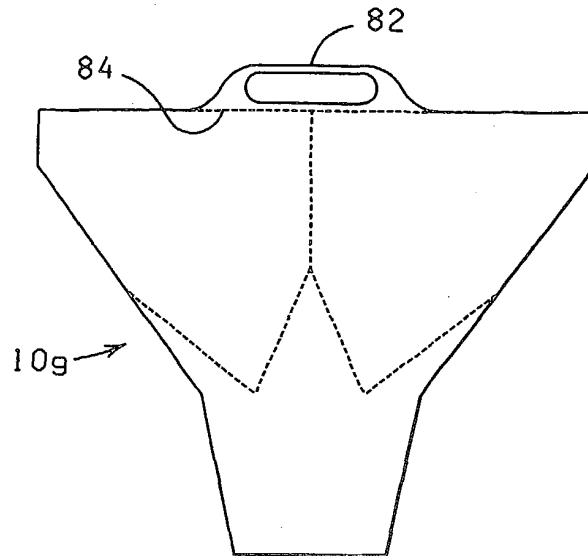
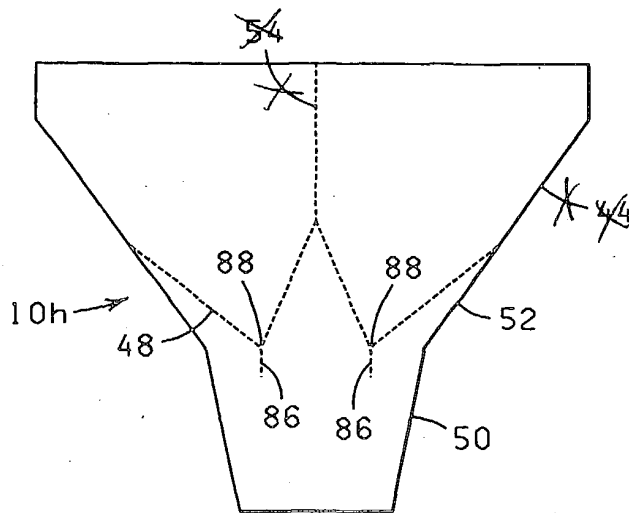
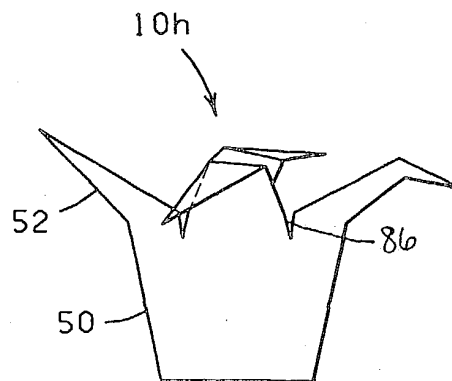


FIG. 13

FIG. 14FIG. 15FIG. 16FIG. 17

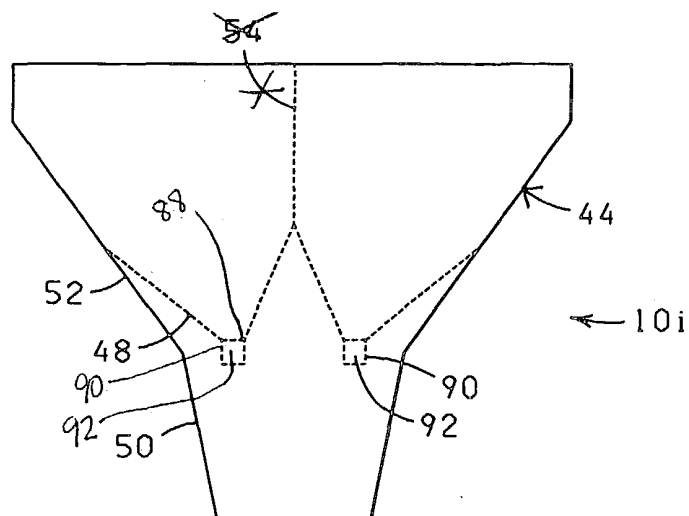


FIG. 18

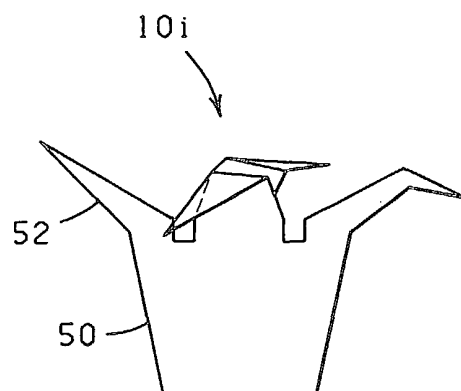


FIG. 19

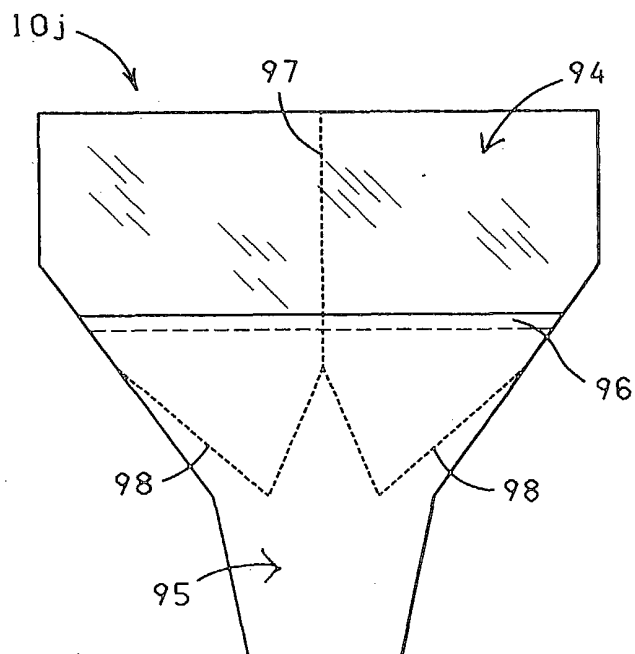


FIG. 20

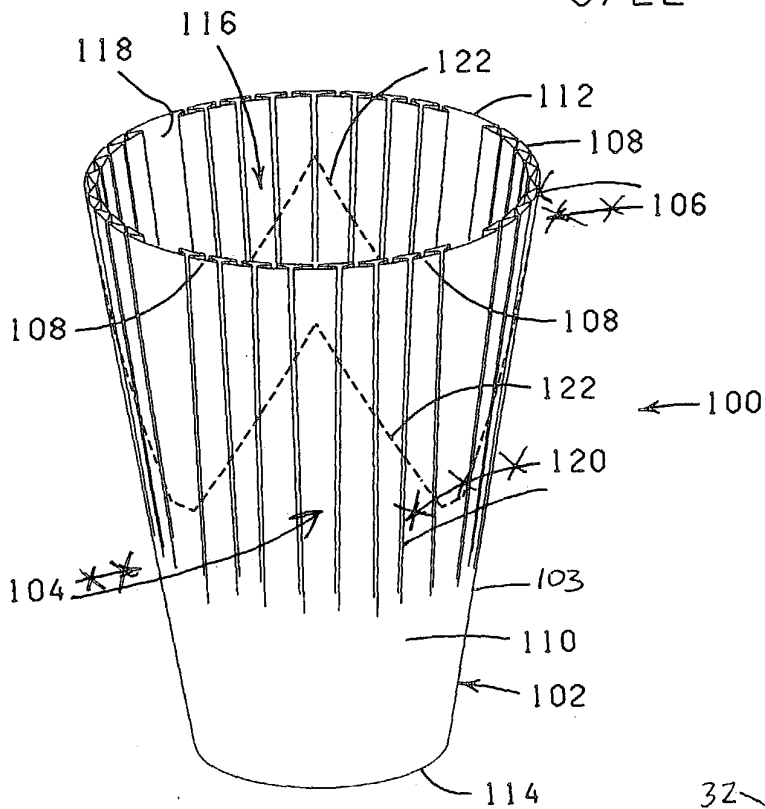


FIG. 21

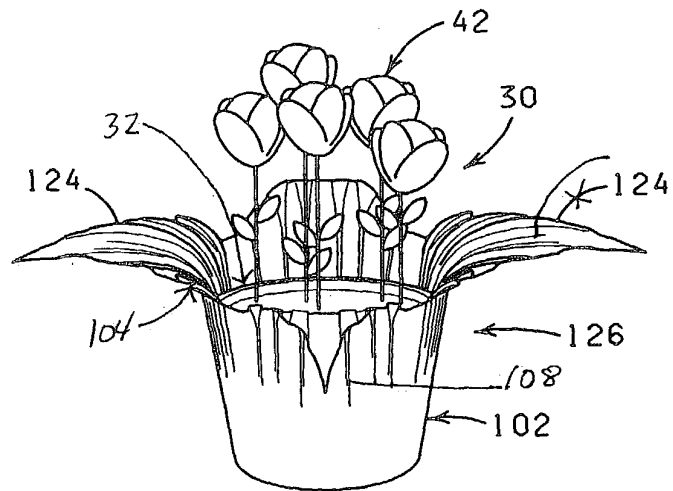


FIG. 22

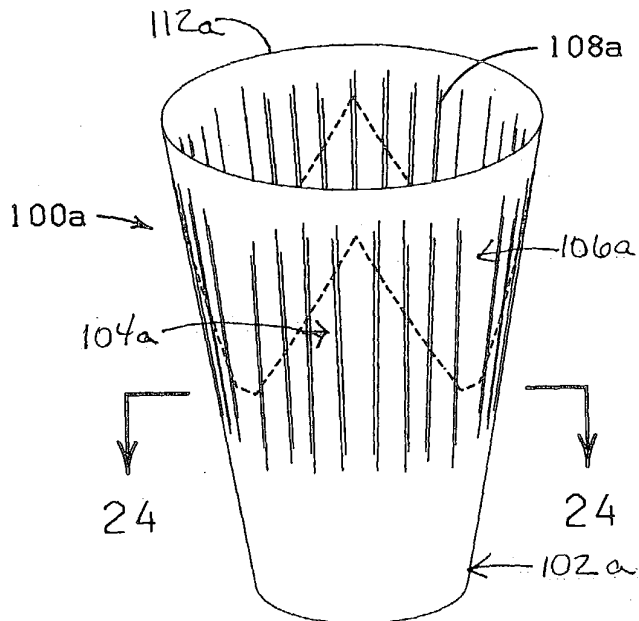


FIG. 23

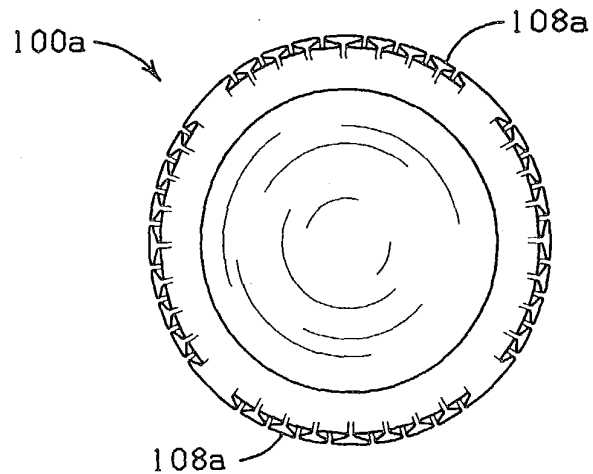


FIG. 24

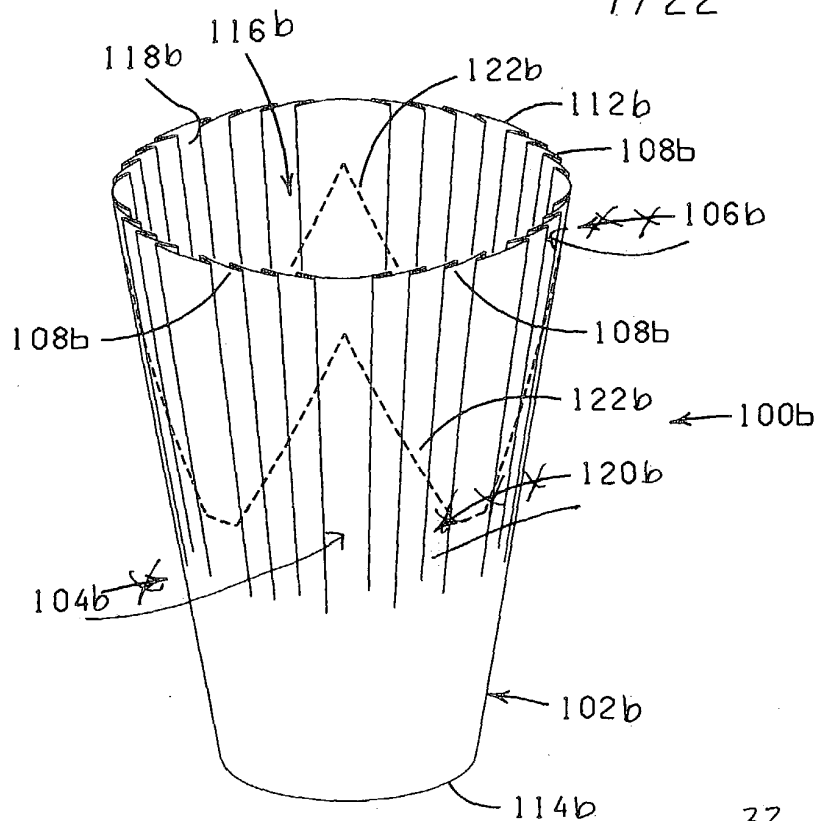


FIG. 25

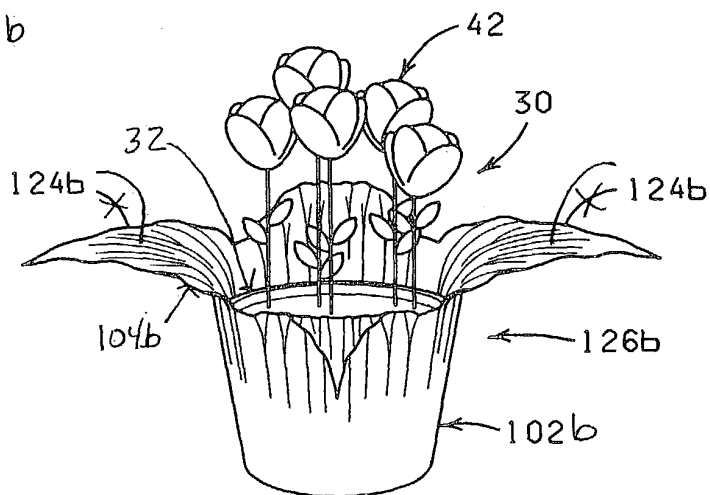


FIG. 26

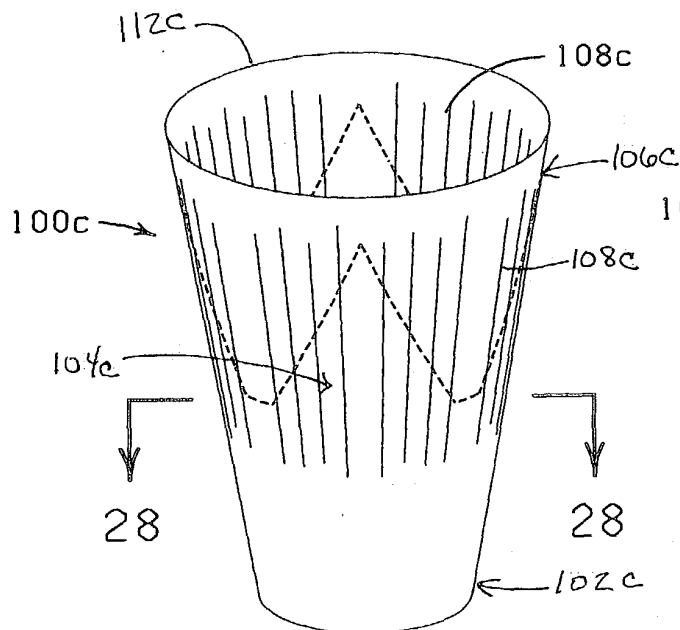


FIG. 27

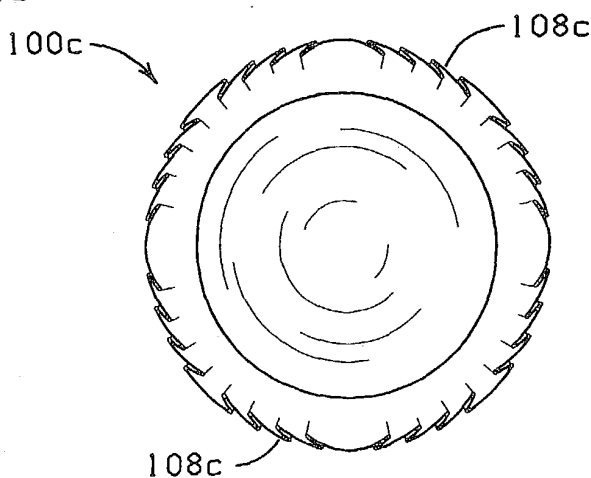


FIG. 28

8/22

Express Mail No.: EV336512866US Deposited: 06/20/2003  
 Title: METHOD OF COVERING A POTTED PLANT  
 Inventors: Donald E. Weder Group: 3644  
 Filed: Herewith Examiner: F. Palo  
 Agent: Christopher W. Corbett Dkt. No.: 8403.888  
 SHEET 8 OF 22 Redline Drawings

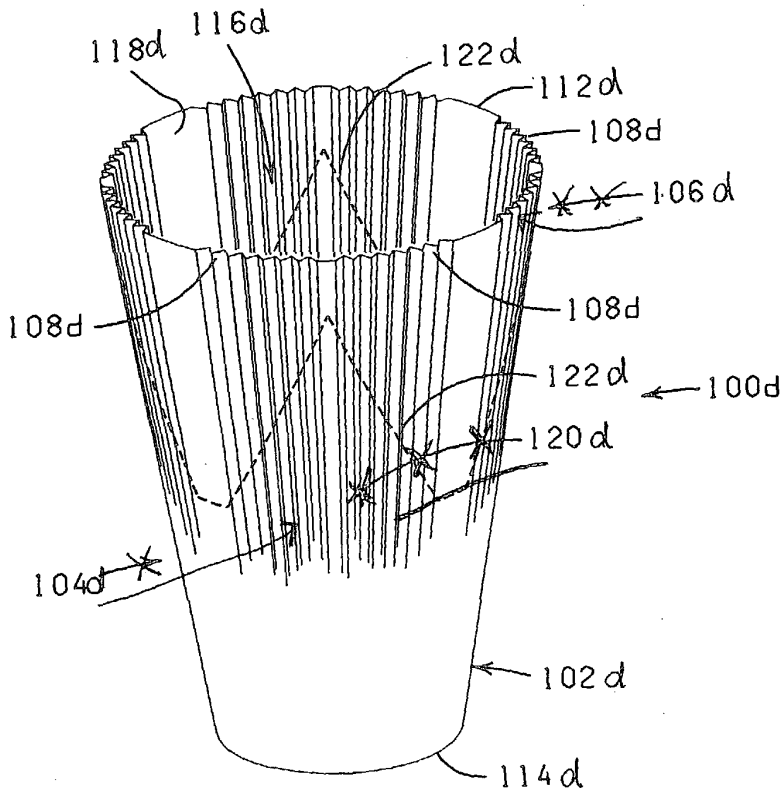


FIG. 28

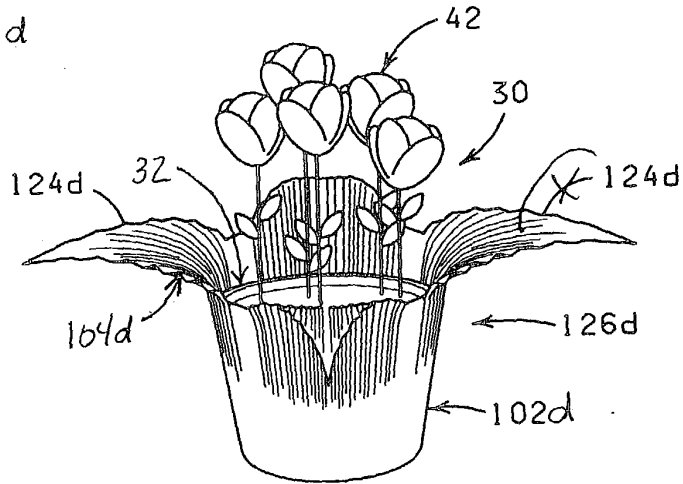


FIG. 29

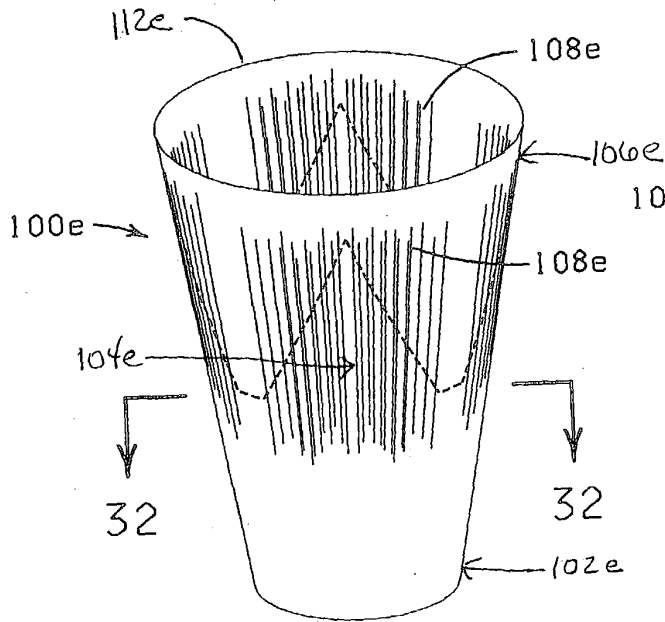


FIG. 31

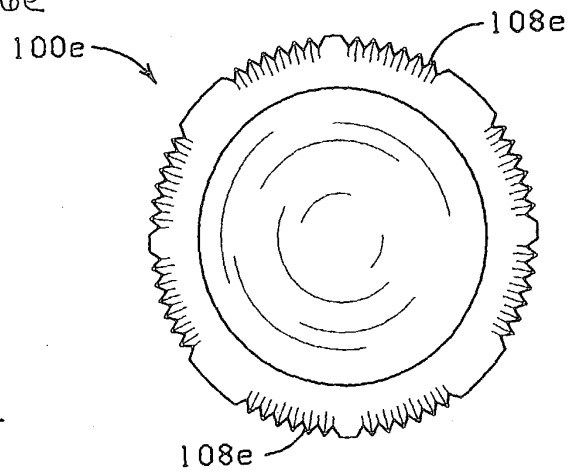


FIG. 32



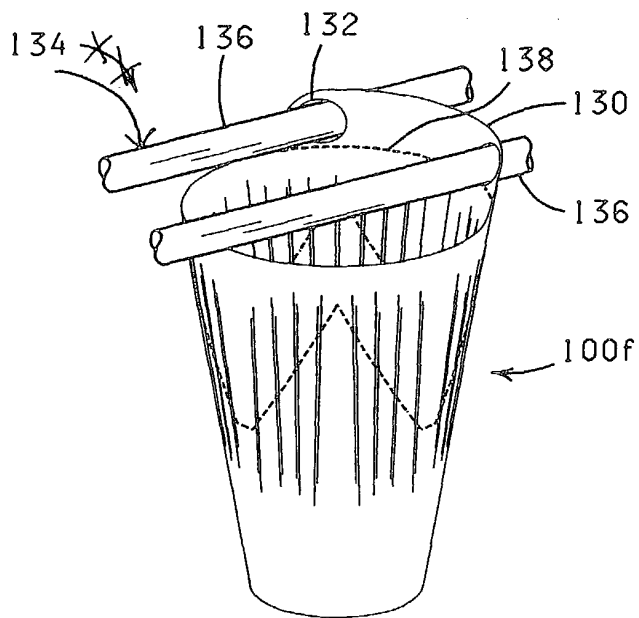


FIG. 33

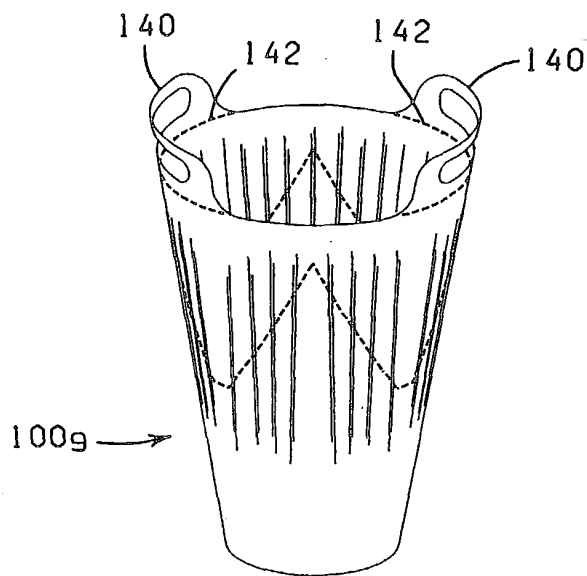


FIG. 34

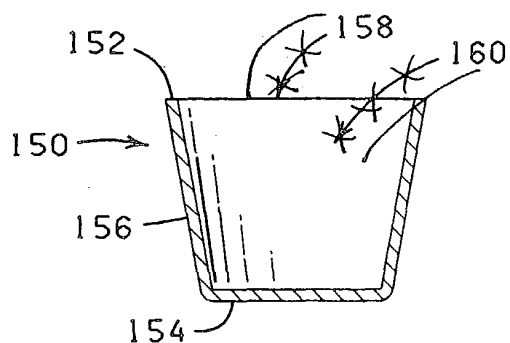


FIG. 35

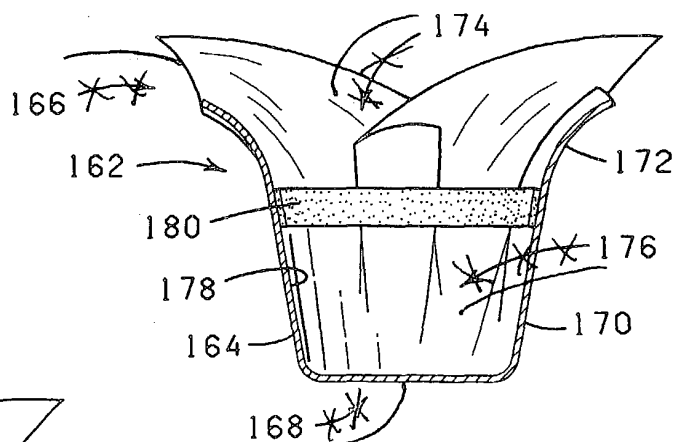


FIG. 36



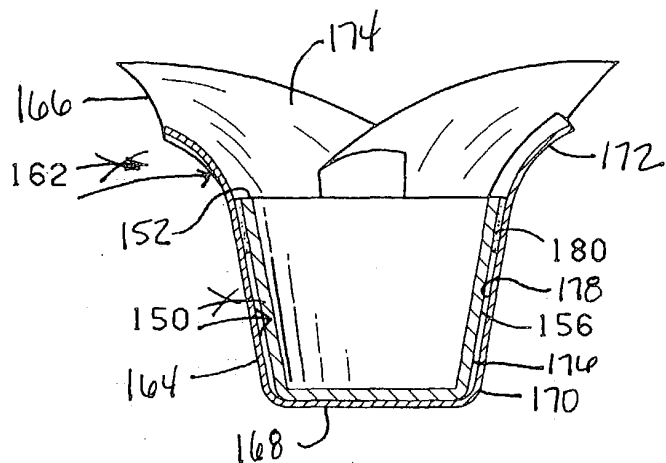


FIG. 37

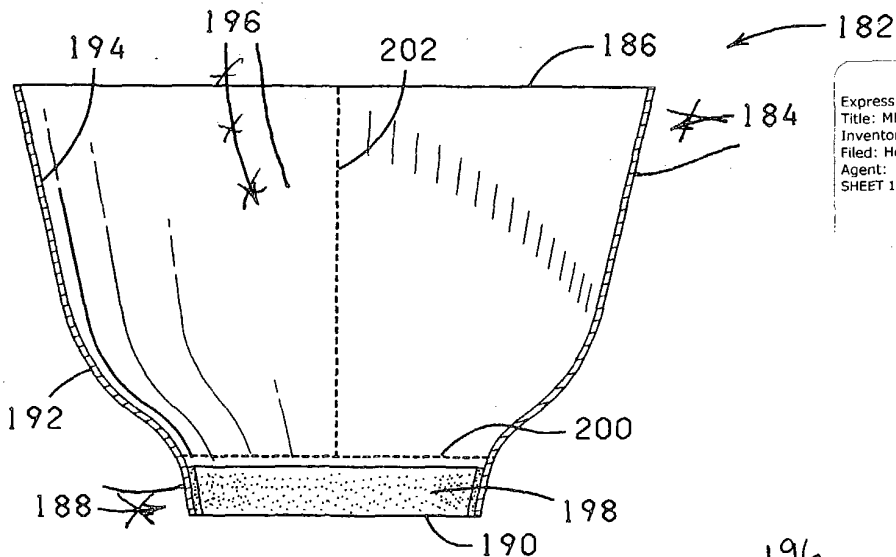


Express Mail No.: EV336512866US Deposited: 06/20/2003  
 Title: METHOD OF COVERING A POTTED PLANT  
 Inventors: Donald E. Weder Group: 3644  
 Filed: Herewith Examiner: F. Palo  
 Agent: Christopher W. Corbett Dkt. No.: 8403.888  
 SHEET 10 OF 22 Redline Drawings


**FIG. 38**

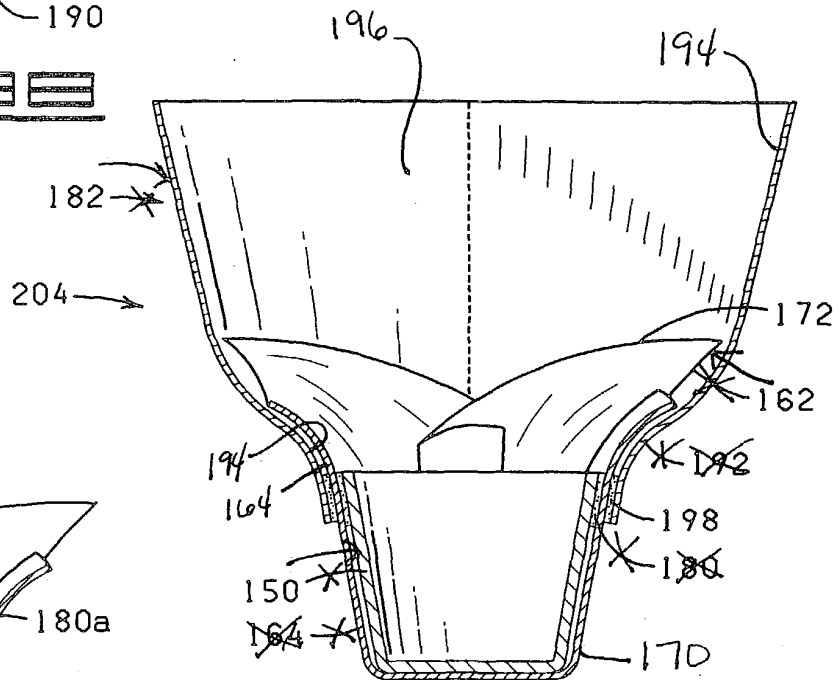

**FIG. 39**

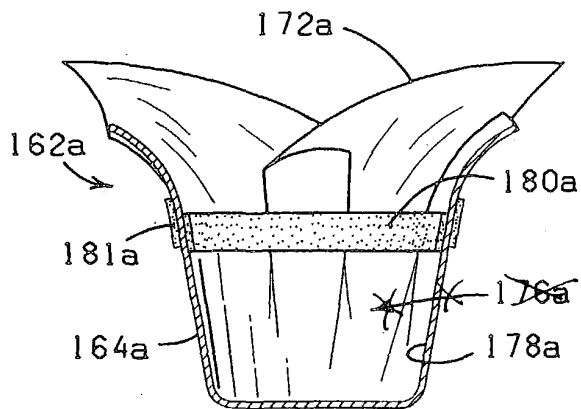

**FIG. 40**

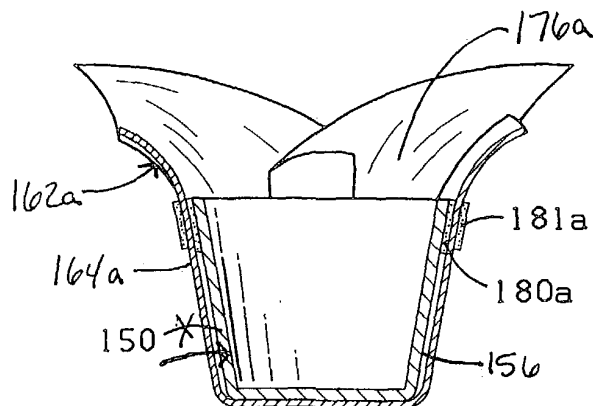

**FIG. 41**

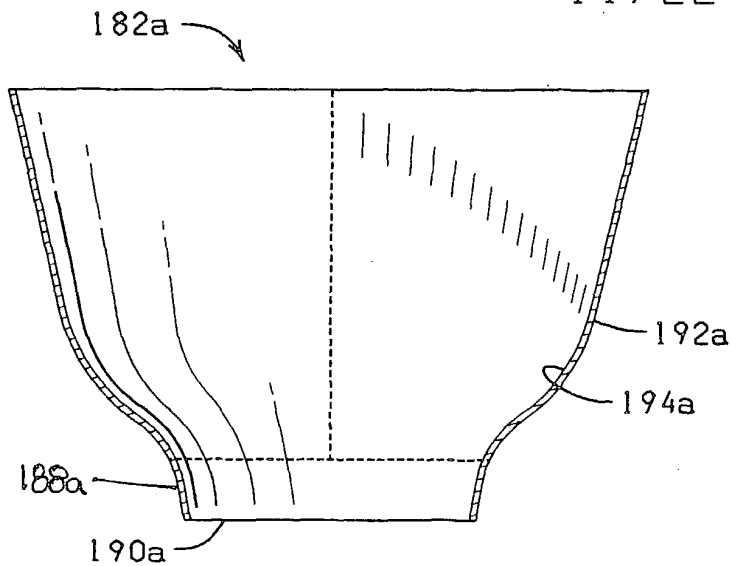


FIG. 42

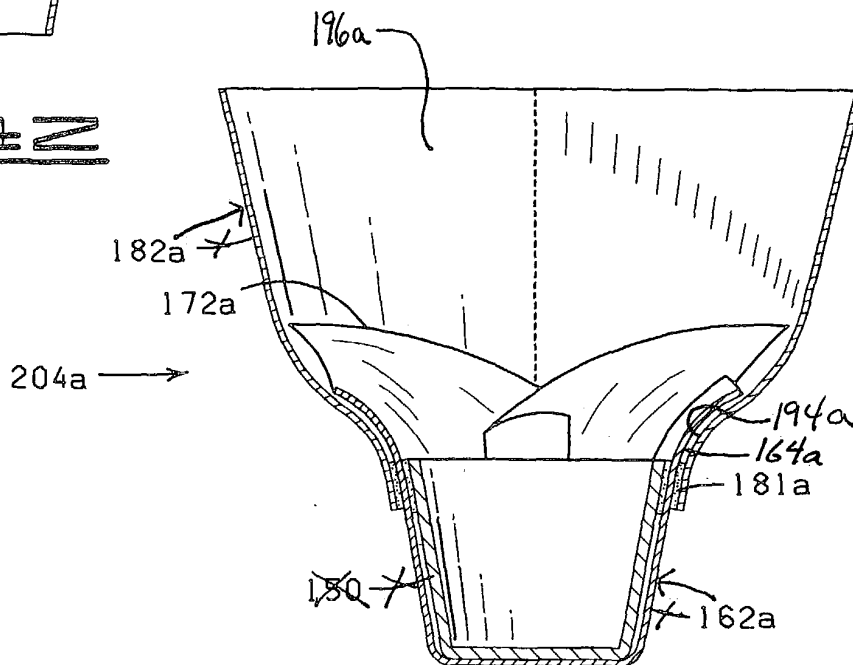


FIG. 43

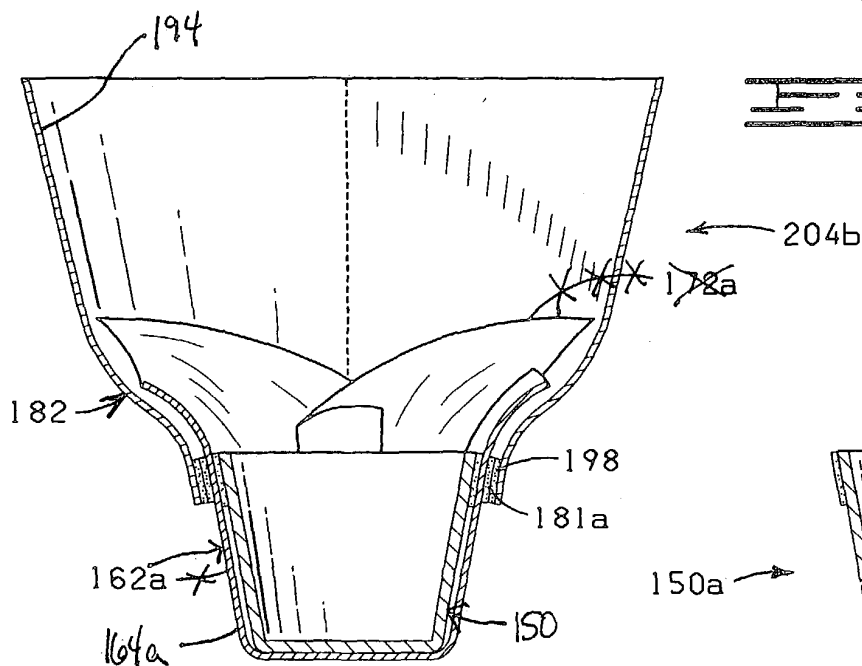


FIG. 44

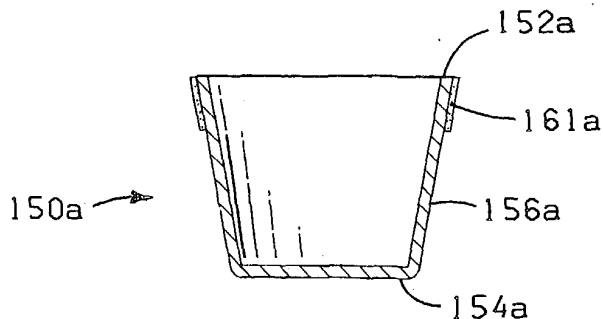


FIG. 45

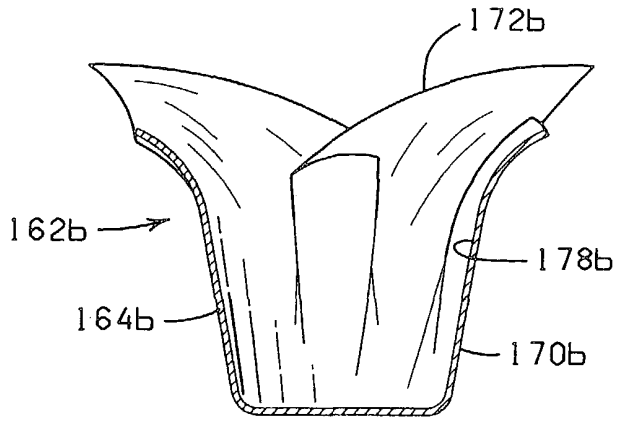


FIG. 46

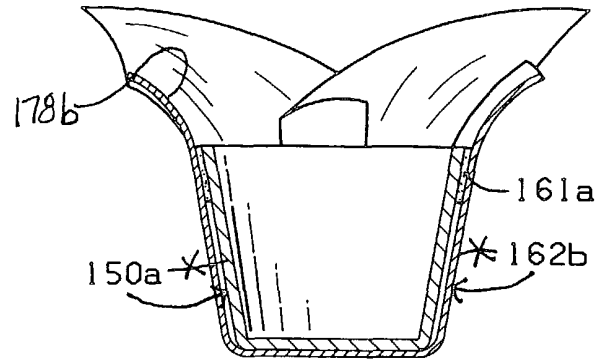


FIG. 47

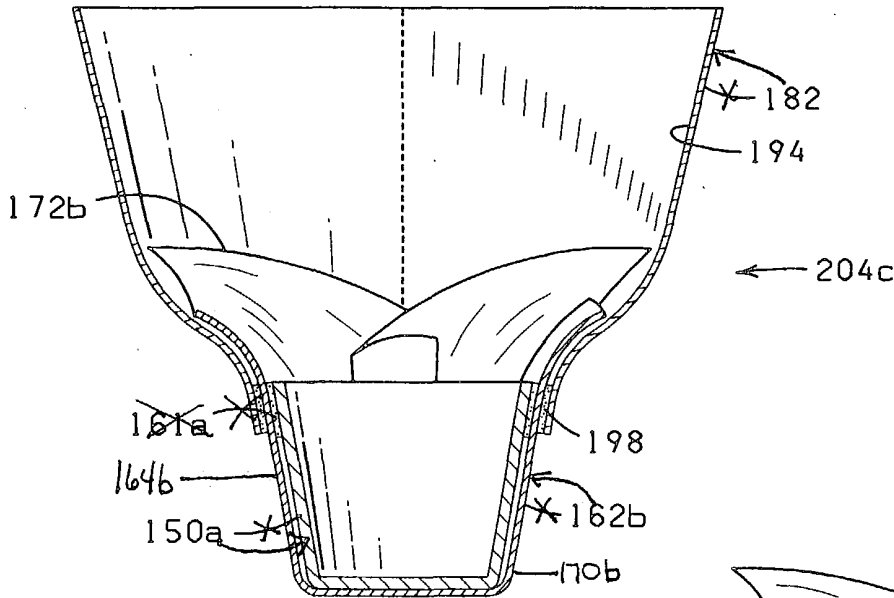


FIG. 48

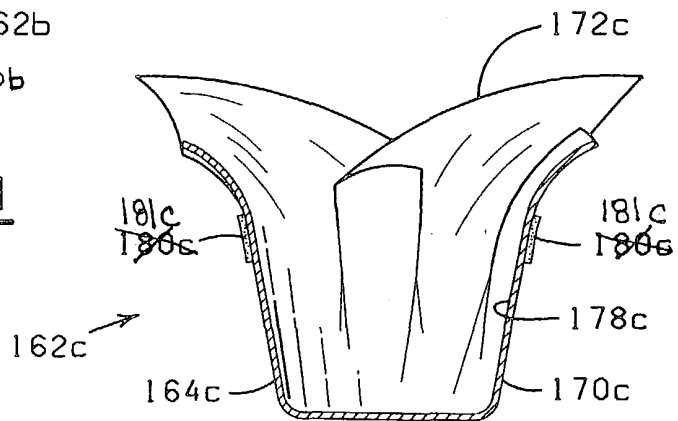
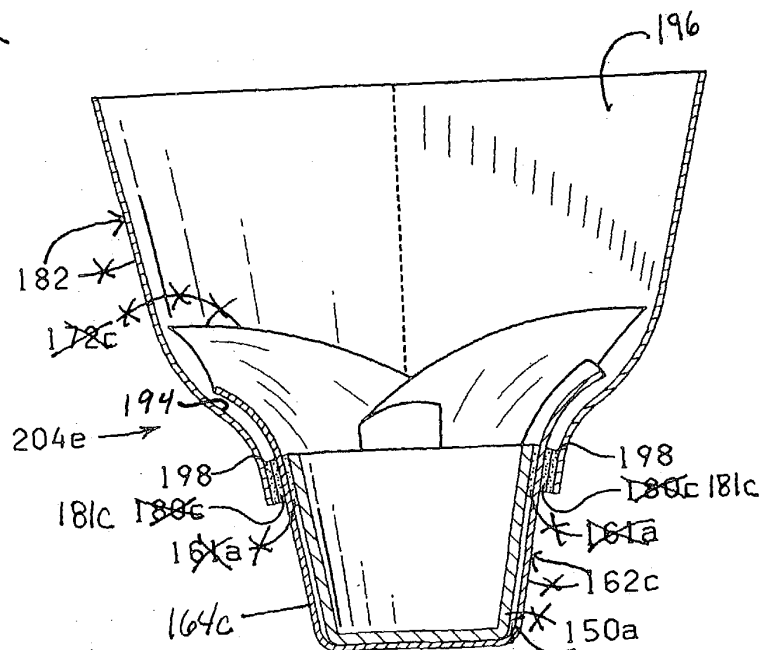
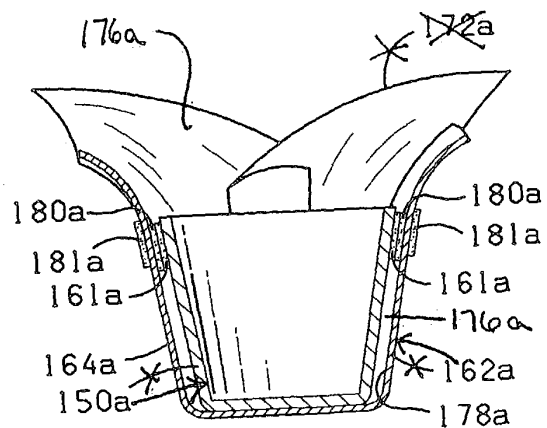
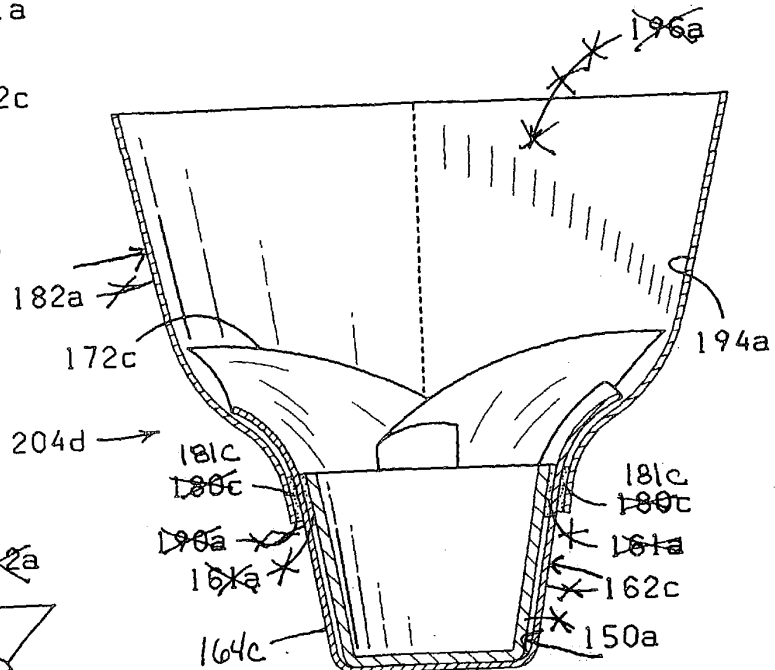
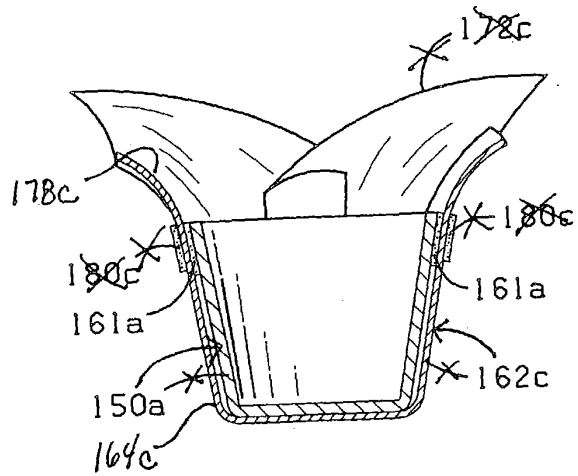
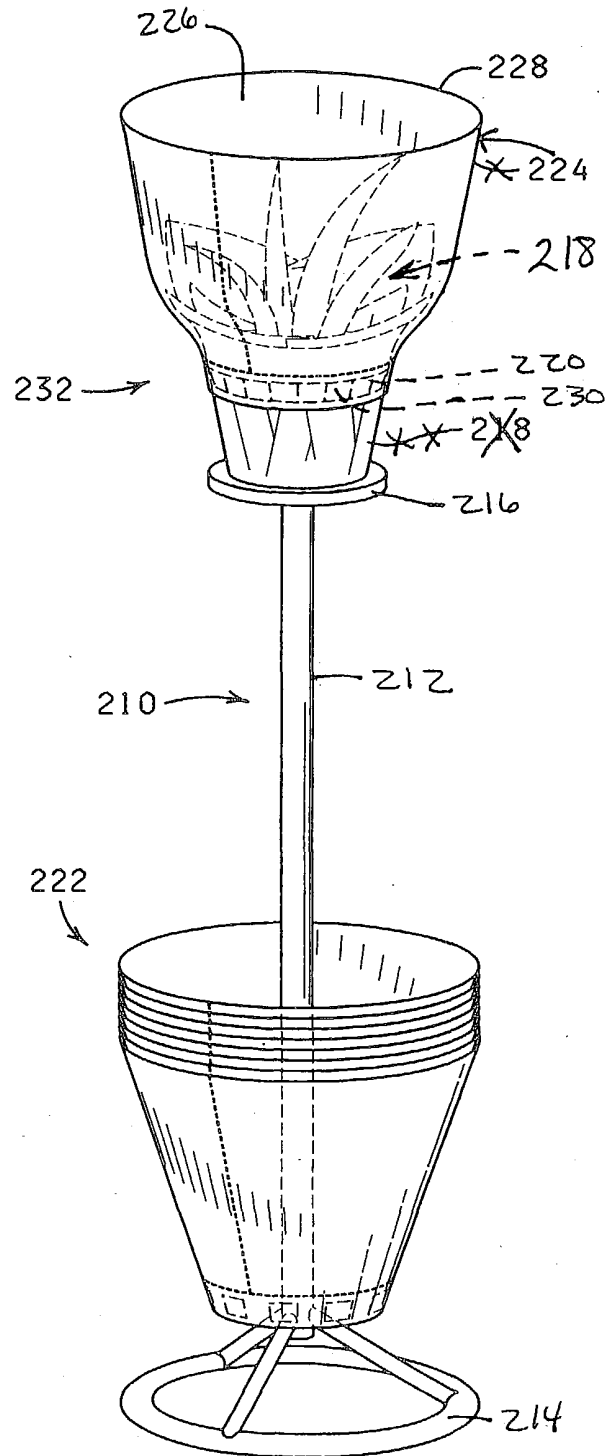
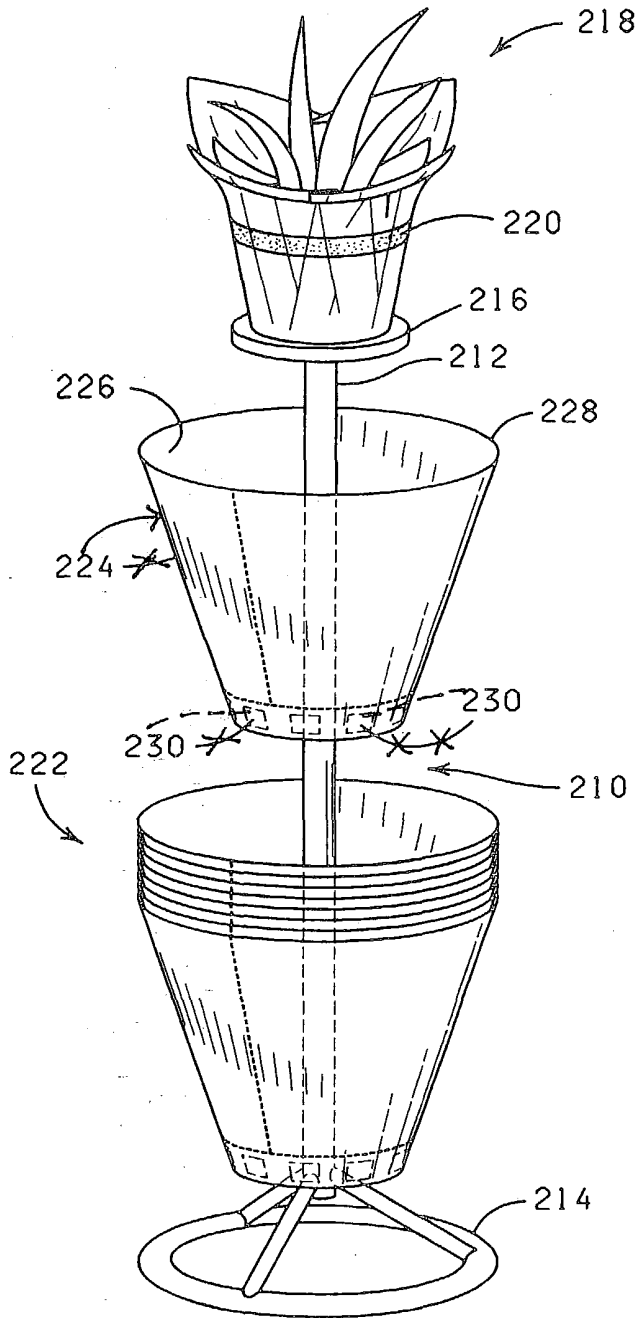


FIG. 49





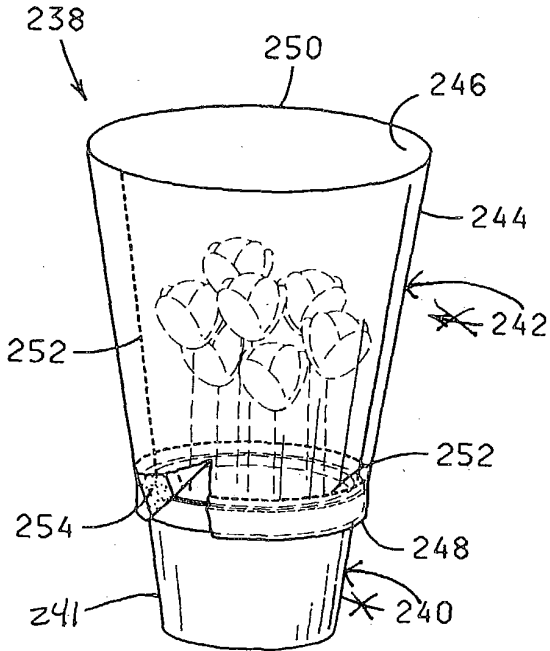


FIG. 5B

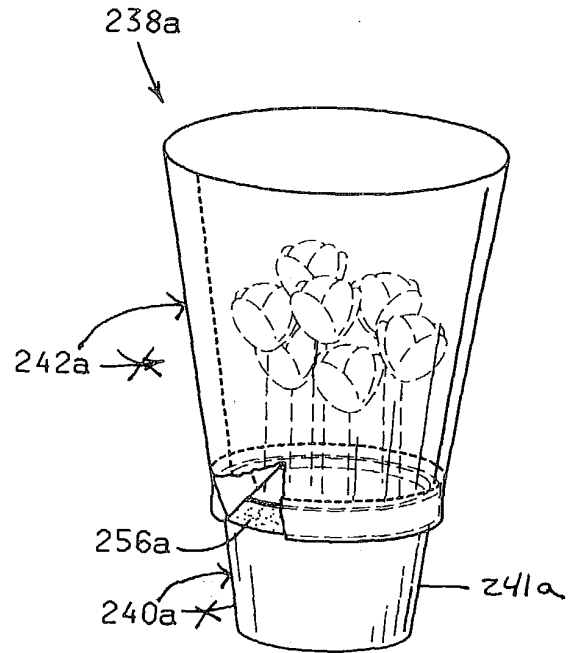


FIG. 5C

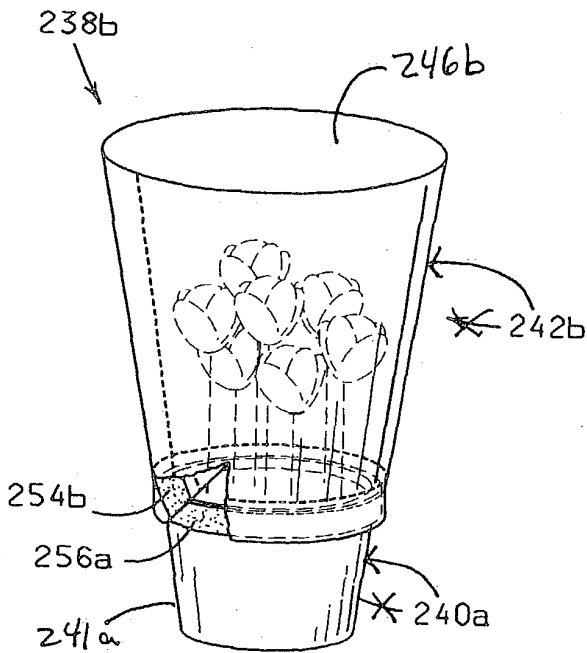


FIG. 5D

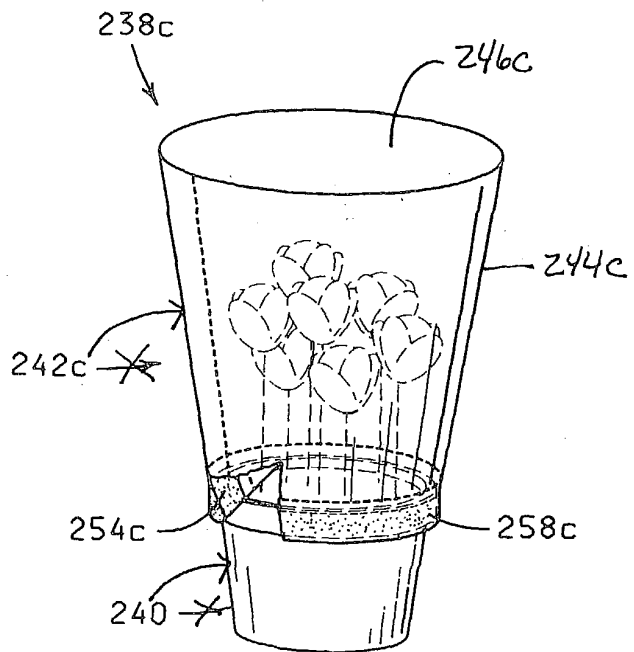


FIG. 5E

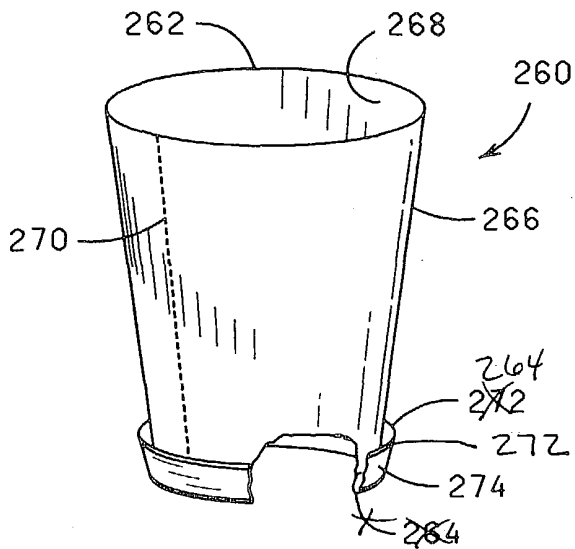


FIG. 60

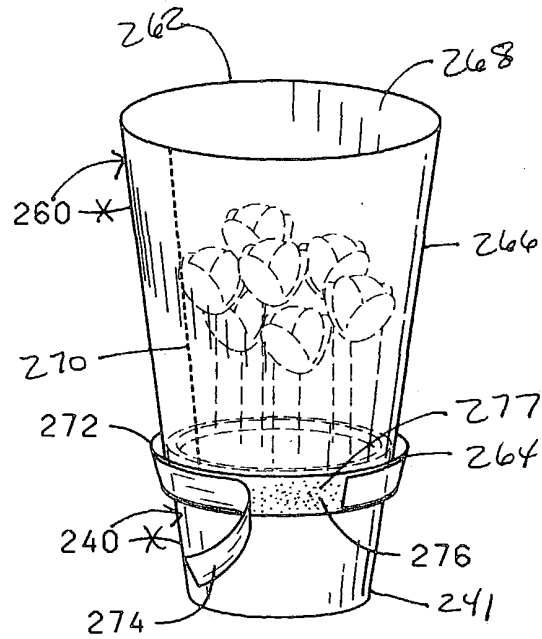


FIG. 61

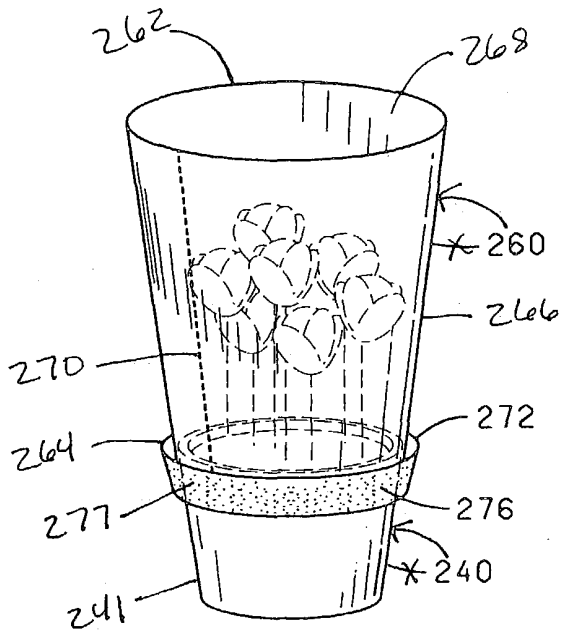


FIG. 62

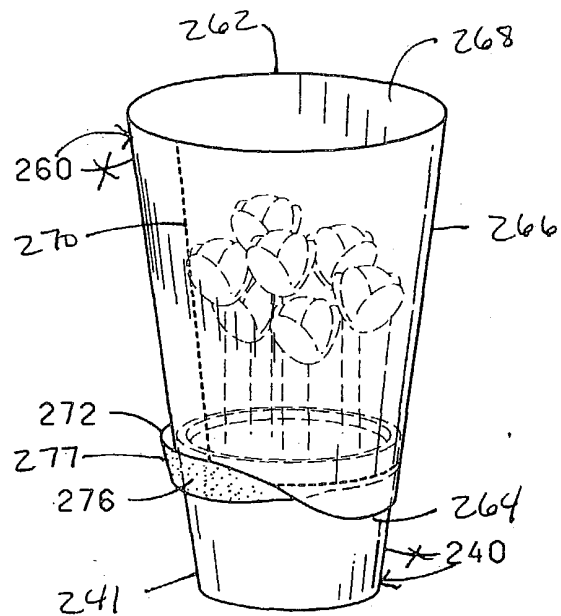


FIG. 63



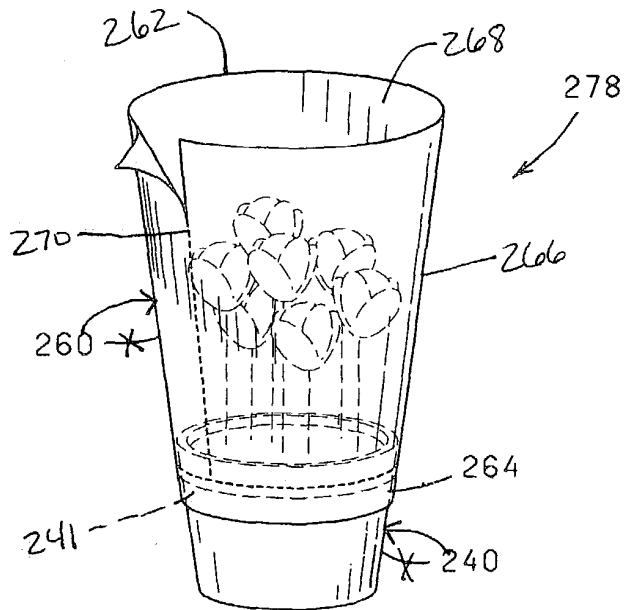


FIG. 64

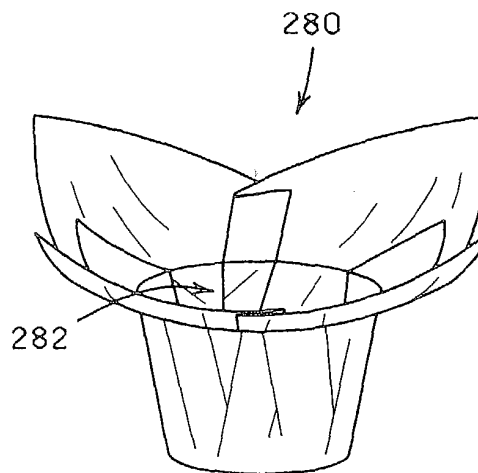


FIG. 65

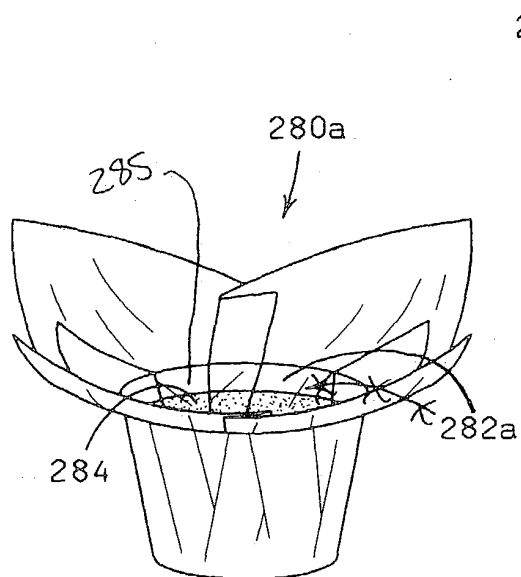


FIG. 66

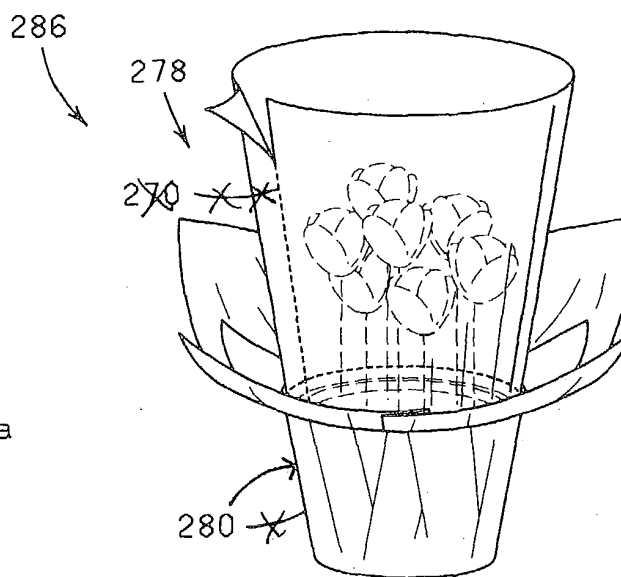


FIG. 67

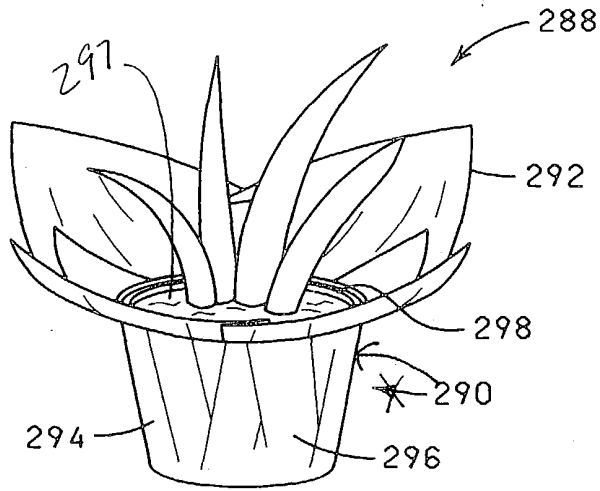


FIG. 28

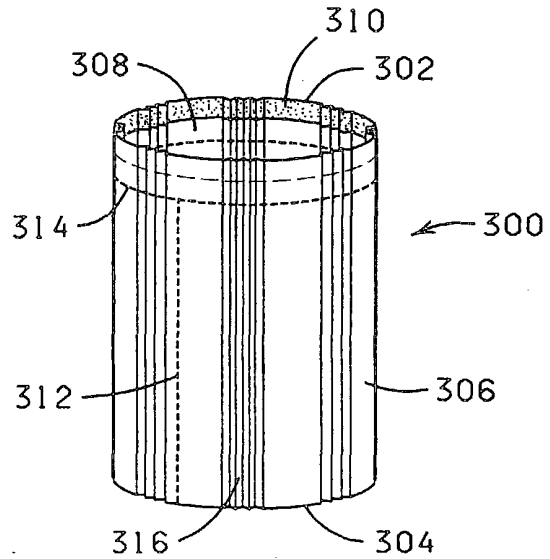


FIG. 29

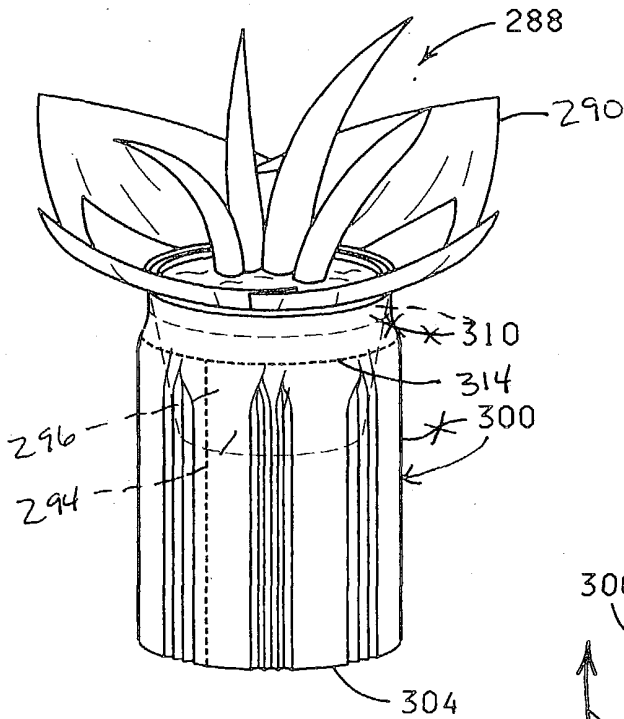


FIG. 30



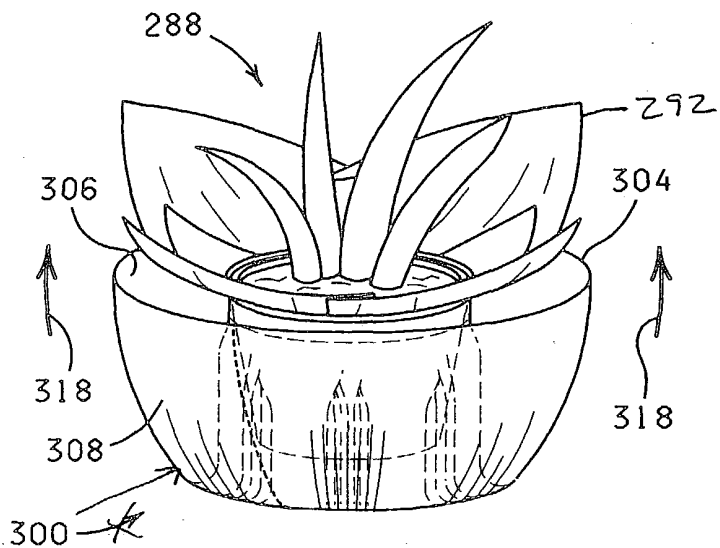



FIG. 31

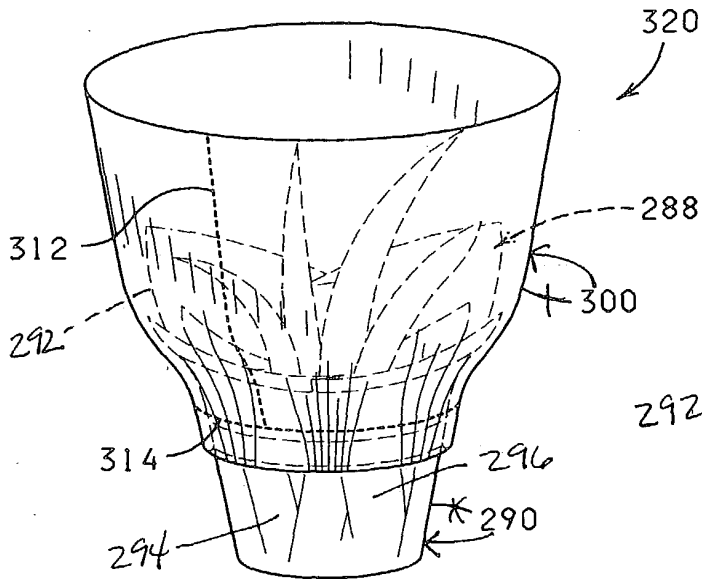


**FIG. 12**

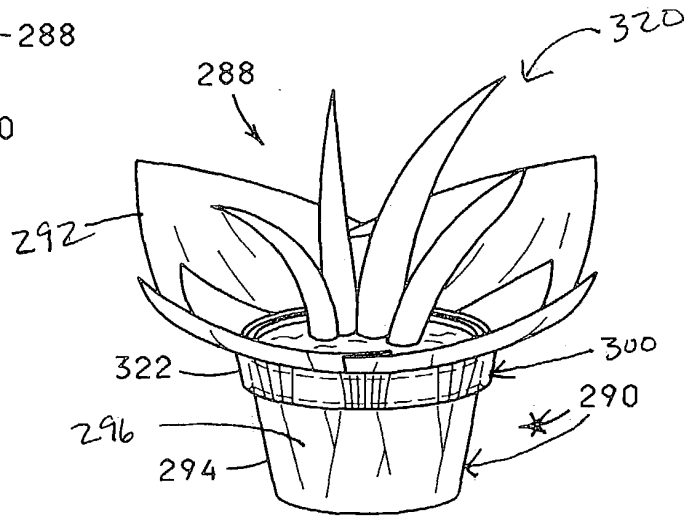

**FIG. 13**

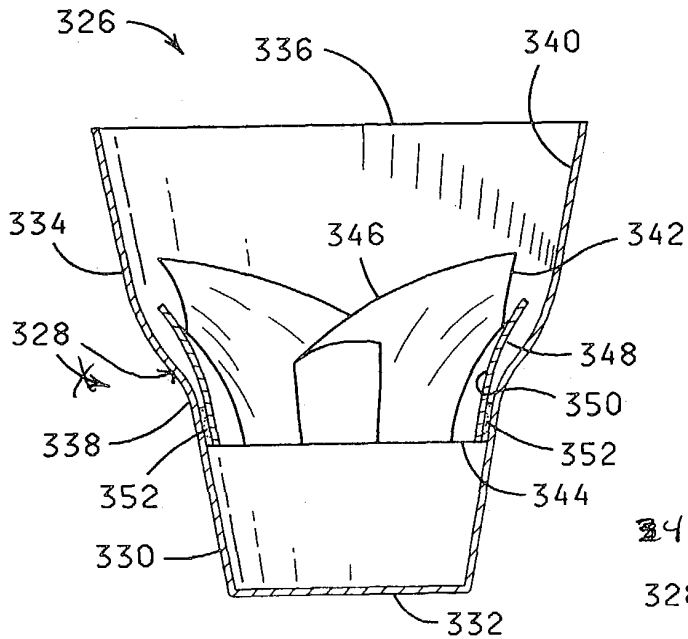

**FIG. 14**

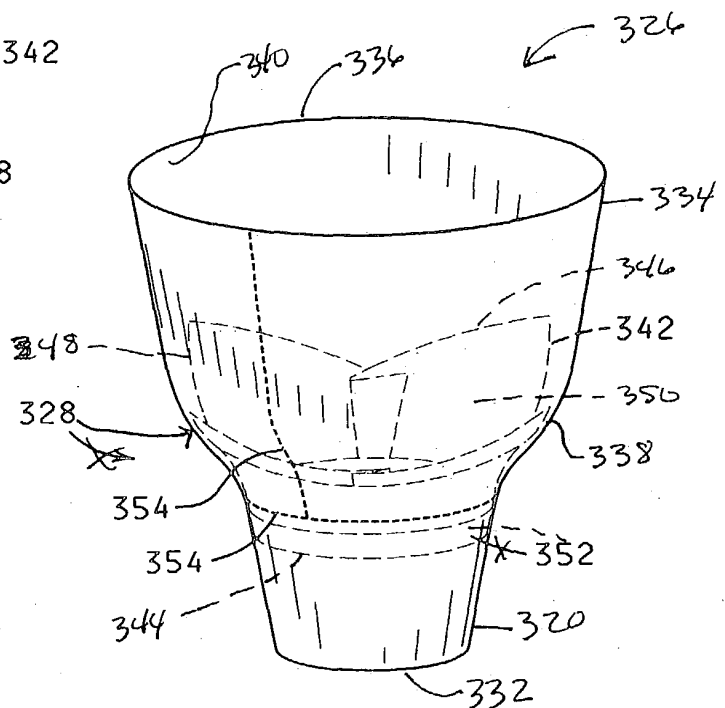

**FIG. 15**

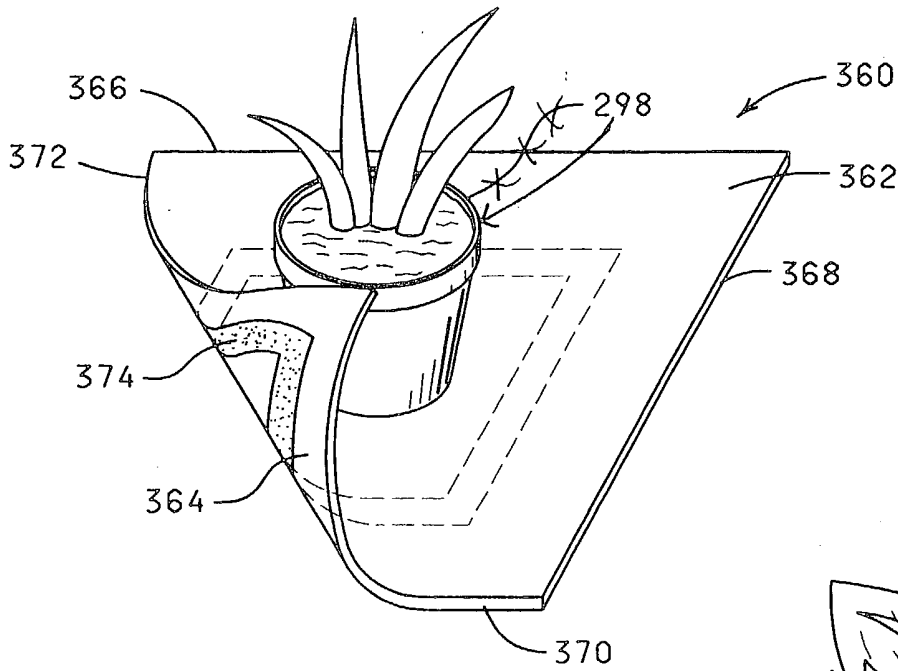


FIG. 26

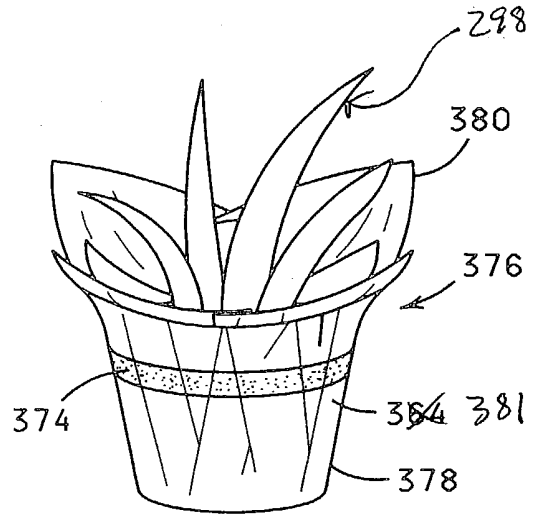


FIG. 27

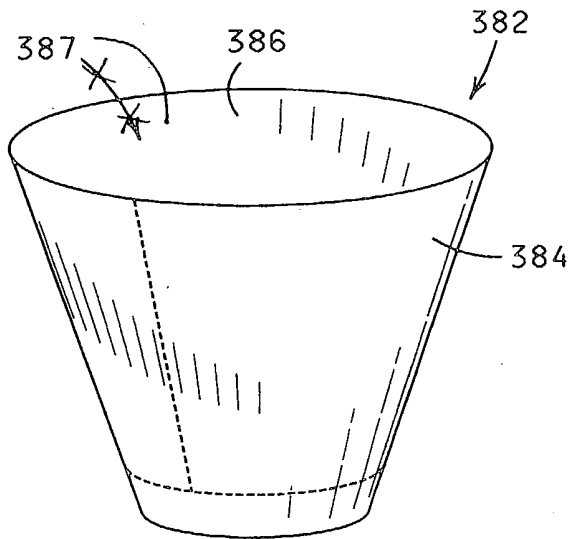


FIG. 28

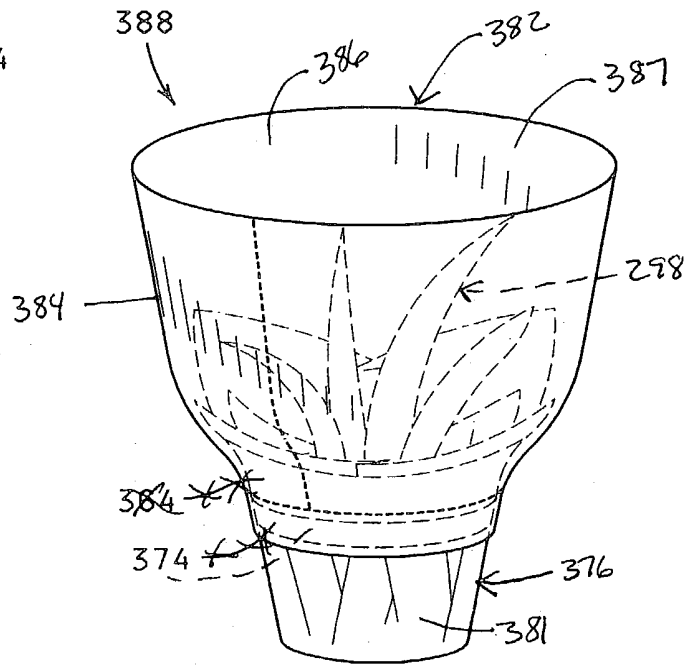
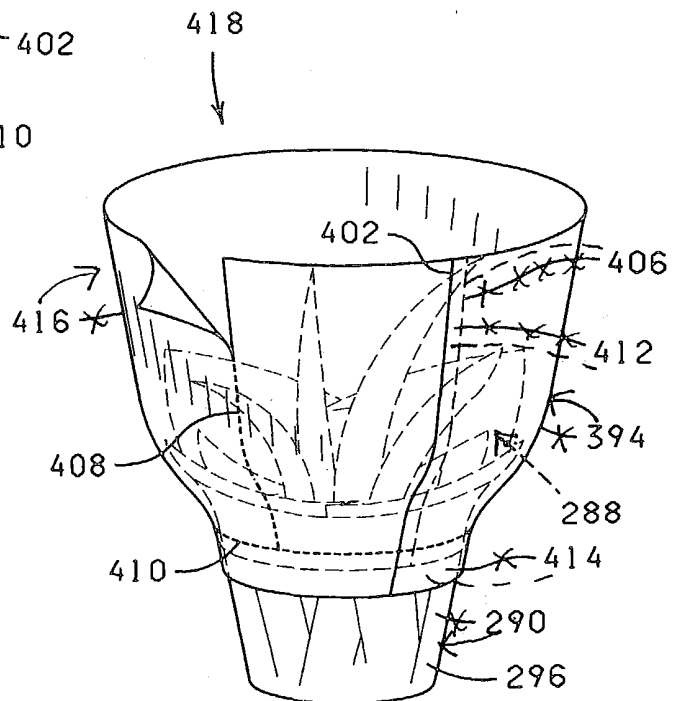
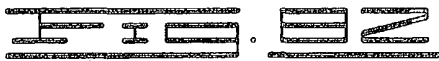
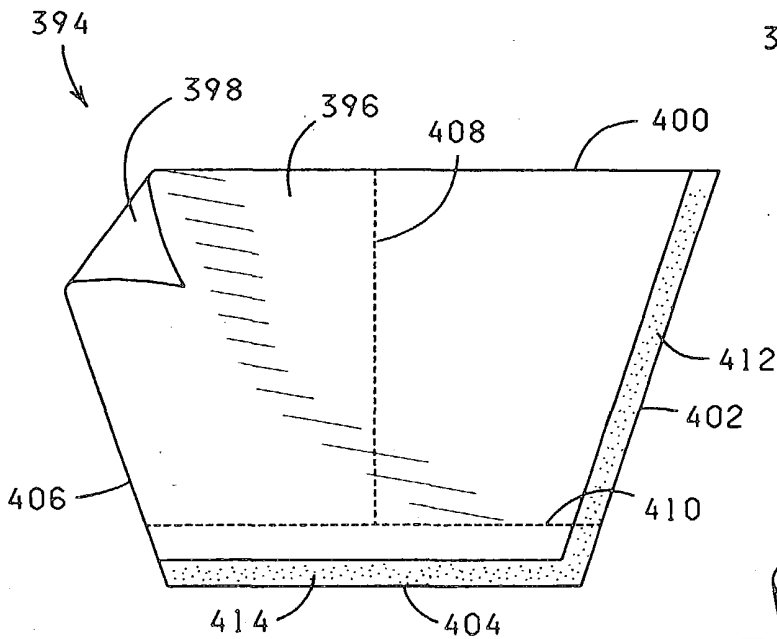
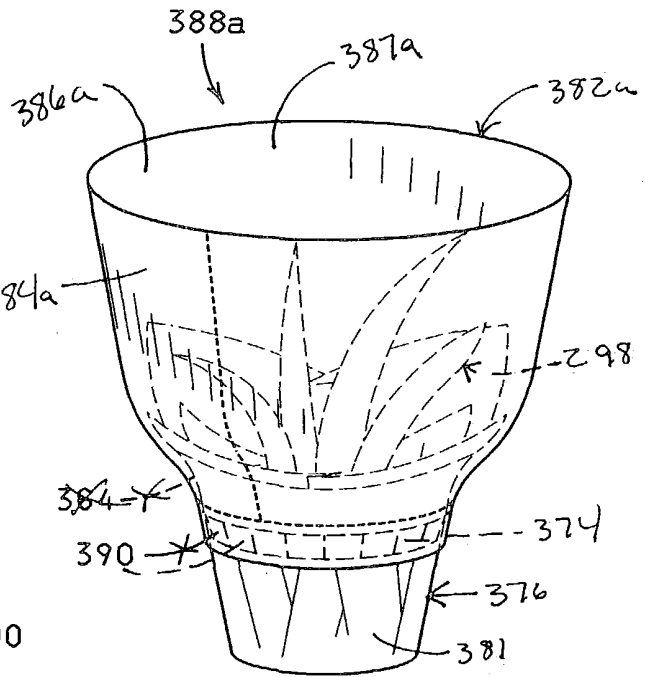
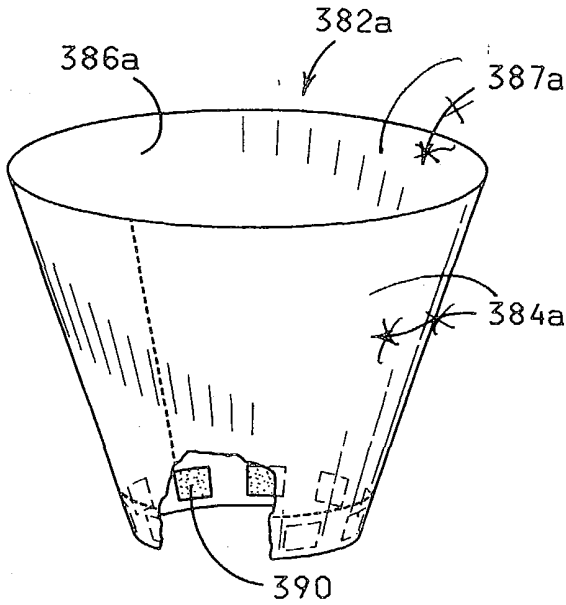


FIG. 29



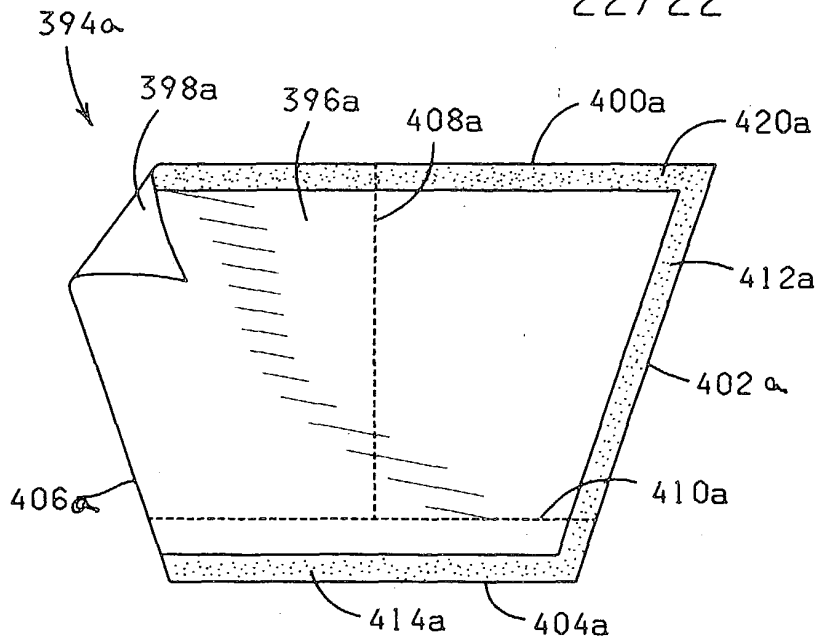


FIG. 24

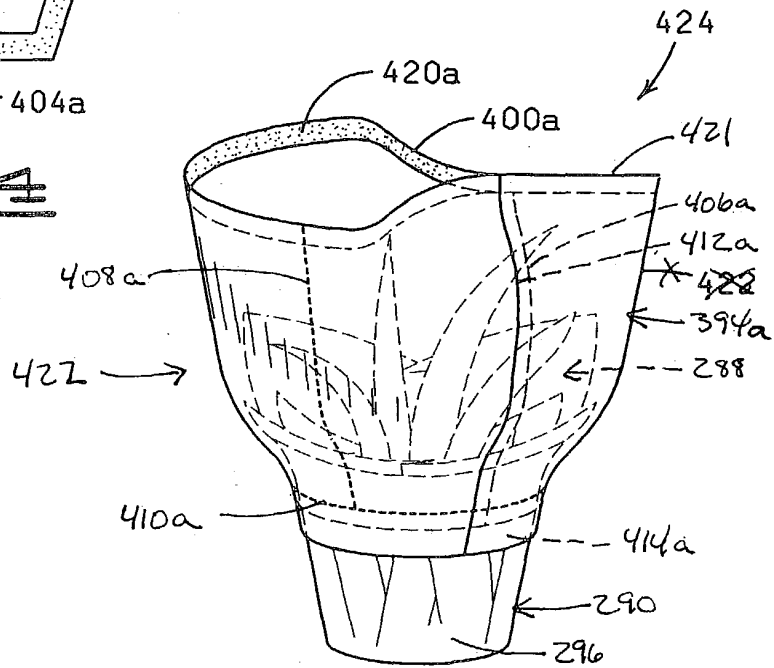


FIG. 25

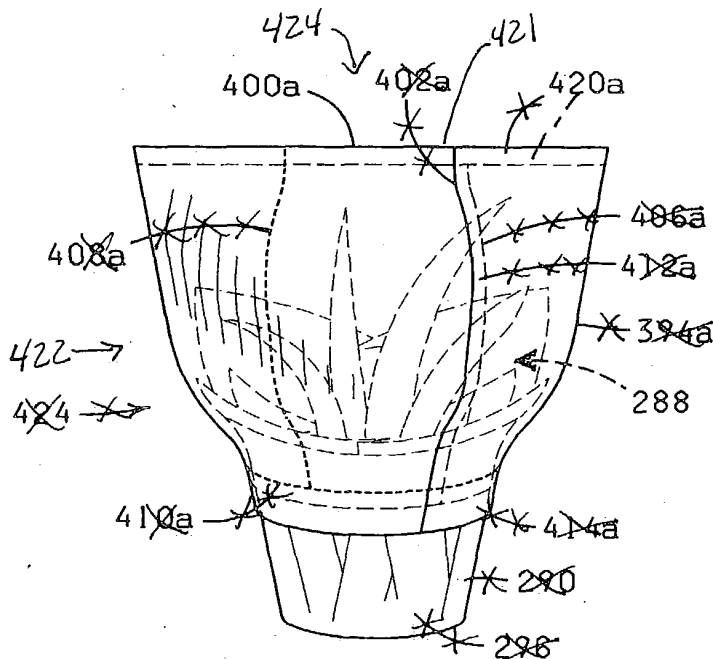


FIG. 26